



**Request for Bid
John's Creek Interceptor CIPP Addendum No. 1 to
RFB No. 196182.71.0395
June 23, 2017**



The following information encompasses Addendum No. 1 for the above referenced RFB. Bidders shall fully consider and acknowledge this Addendum in the preparation and submittal of its formal Bid. Failure to do so may result in the rejection of the Bid.

Section 1 – Mandatory Pre-Bid Meeting Notes and Sign-In Sheet

Section 2 – Technical Drawing NS-9 PP 17

All other conditions and requirements remain unchanged.

**Section 1
Pre-Bid Meeting Notes and Sign-In Sheet**

Q1: What is the slope of the sanitary sewer line that is being rehabilitated?

SARP10: The as-builts drawings show a slope of 0.10%. SARP10 cannot verify the actual slope for this line. See plans included in this Addendum.

Q2: There is an existing sinkhole by one of the manholes scoped in this project, will it get fixed prior to work starting?

SARP10: The manhole that is adjacent to the sinkhole belongs to a private utility. We will inspect sinkhole once work begins and determine what type of remediation is required. The sewer rehabilitation contractor is not expected to fix sinkhole.



SIGN-IN SHEET

Project: SARP10	Meeting Date: June 22, 2017
Meeting: John's Creek CIPP	Time: 9:30 AM – 11:00 AM
Facilitator: Josh Grabowski	Place/Room: Ben Hooks Library

Name	Company	Phone	E-Mail
Stephen Starks	CCM	901-430-5002	SE sstarks@ccmine.us
RANDY HANSBROUGH	SAK	901-268-5526	RHANSBROUGH@SAKCON.COM
DAVE VANDEWATER	INSITUFORM	615-427-3809	dvandewater@aregion.com
Terrell Richards	WFT	901-331-1780	terrellrichards250@gmail.com
KEITH ASHER	CTR COATINGS	770-598-8888	keith@ctrcoatings.com
JAMES HINTE	MUC	901-238-7985	JHINTE@MAGNOLIAUNDERGROUND.US



SIGN-IN SHEET

Project: SARP10	Meeting Date: June 22, 2017
Meeting: John's Creek CIPP	Time: 9:30 AM – 11:00 AM
Facilitator: Josh Grabowski	Place/Room: Ben Hooks Library

Name	Company	Phone	E-Mail
Justin Avent	SARP10	901-849-6554	justin-avent@gspnet.com
Scott McAmis	SARP10	865-869-8618	scott-mcamis@gsprut.com
Josh Grabowski	SARP10	870-514-1715	Josh.Grabowski@rccsc.net
Wiley Richards	WRT	9049971201	WileyRichards@MSN.COM
Riley Thompson	SARP10	904952649	Thompson LR@BU.com
Gary Older	SARP10	813-323-0502	oldergs@bu.com
Steve Anderson	LAUNE/Online	901-274-2324	steve.anderson@laune.com



SIGN-IN SHEET

Project: SARP10	Meeting Date: June 22, 2017
Meeting: John's Creek CIPP	Time: 9:30 AM – 11:00 AM
Facilitator: Josh Grabowski	Place/Room: Ben Hooks Library



NAME	COMPANY	PHONE	E-MAIL
Stephen Starks	CCM	901-430-5022	sstarks@ccminc.us
Randy Hansbrough	SAK	901-268-5526	rhansbrough@sakcon.com
Dave Vandewater	Insituform	615-427-3809	dvandewater@aegion.com
Terrell Richards	W&T	901-331-1780	terrellrichards250@gmail.com
Keith Asher	CTR Coatings	770-598-8888	keith@ctrcoatings.com
James Hinte	MVC	901-238-7985	jhinte@magnoliaunderground.us
Justin Avent	Gresham Smith(SARP10)	901-849-6554	justin_avent@gspnet.com
Scott McAmis	SARP10	865-809-8618	scott_mcamis@gspnet.com
Josh Grabowski	SARP10	870-514-1715	josh.grabowski@rccsc.net
Wiley Richards	W&T	901-497-1201	wileyrichards@msn.com
Riley Thompson	OCI	606-359-1972	thompsonlr@bv.com
Gary Older	OCI	813-323-0502	oldergs@bv.com
Steve Anderson	Layne Inliner	901-274-2324	steve.anderson@layne.com



**Request for Bid
John's Creek Interceptor CIPP Addendum No. 1 to
RFB No. 196182.71.0395
June 23, 2017**



**Section 2
Technical Drawing NS-9 PP 17**

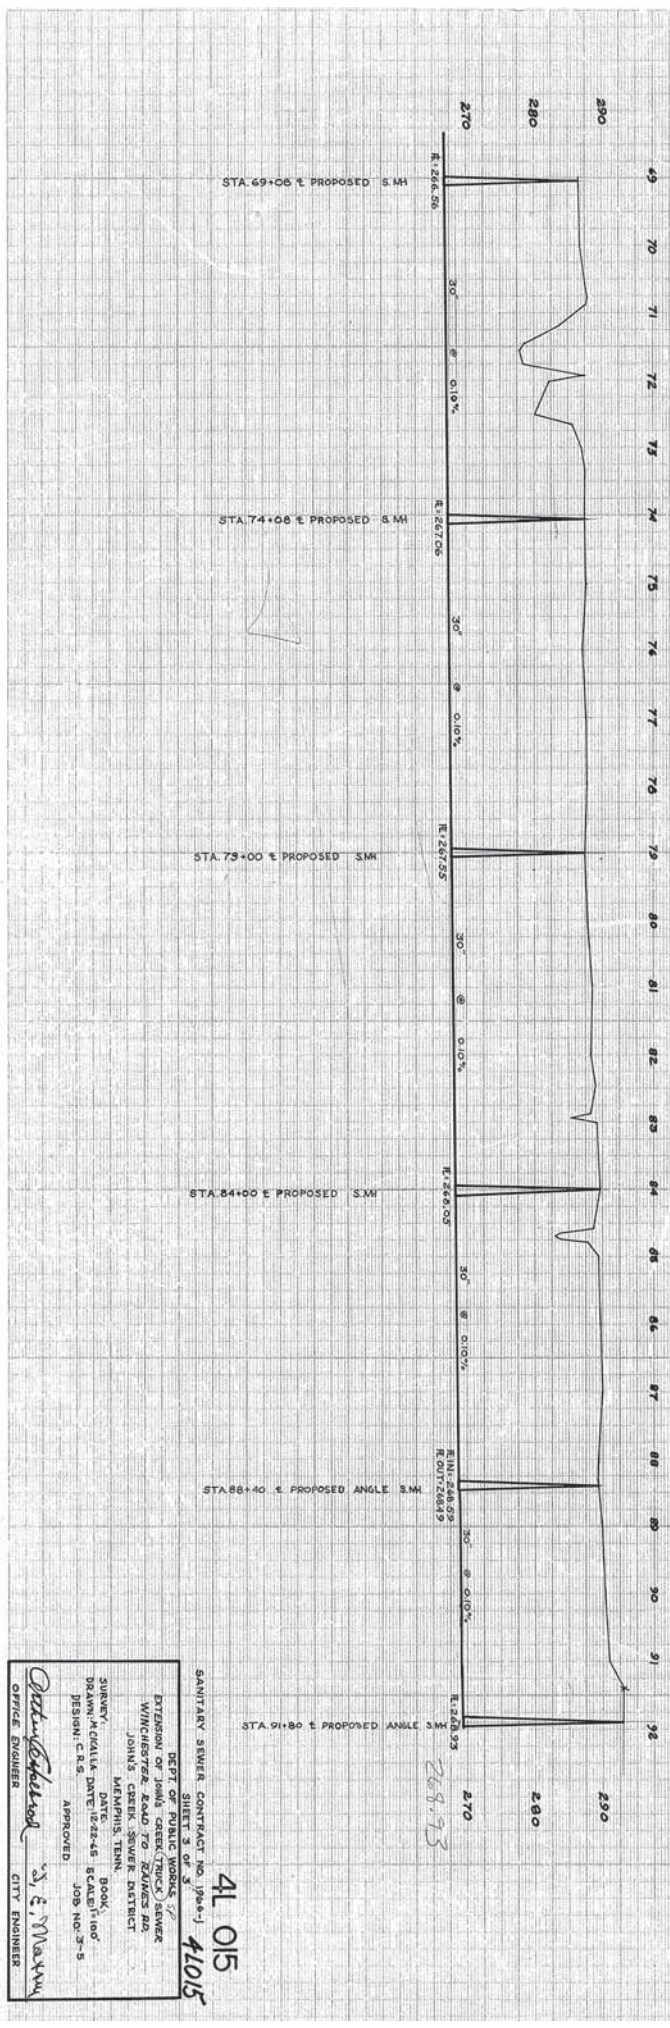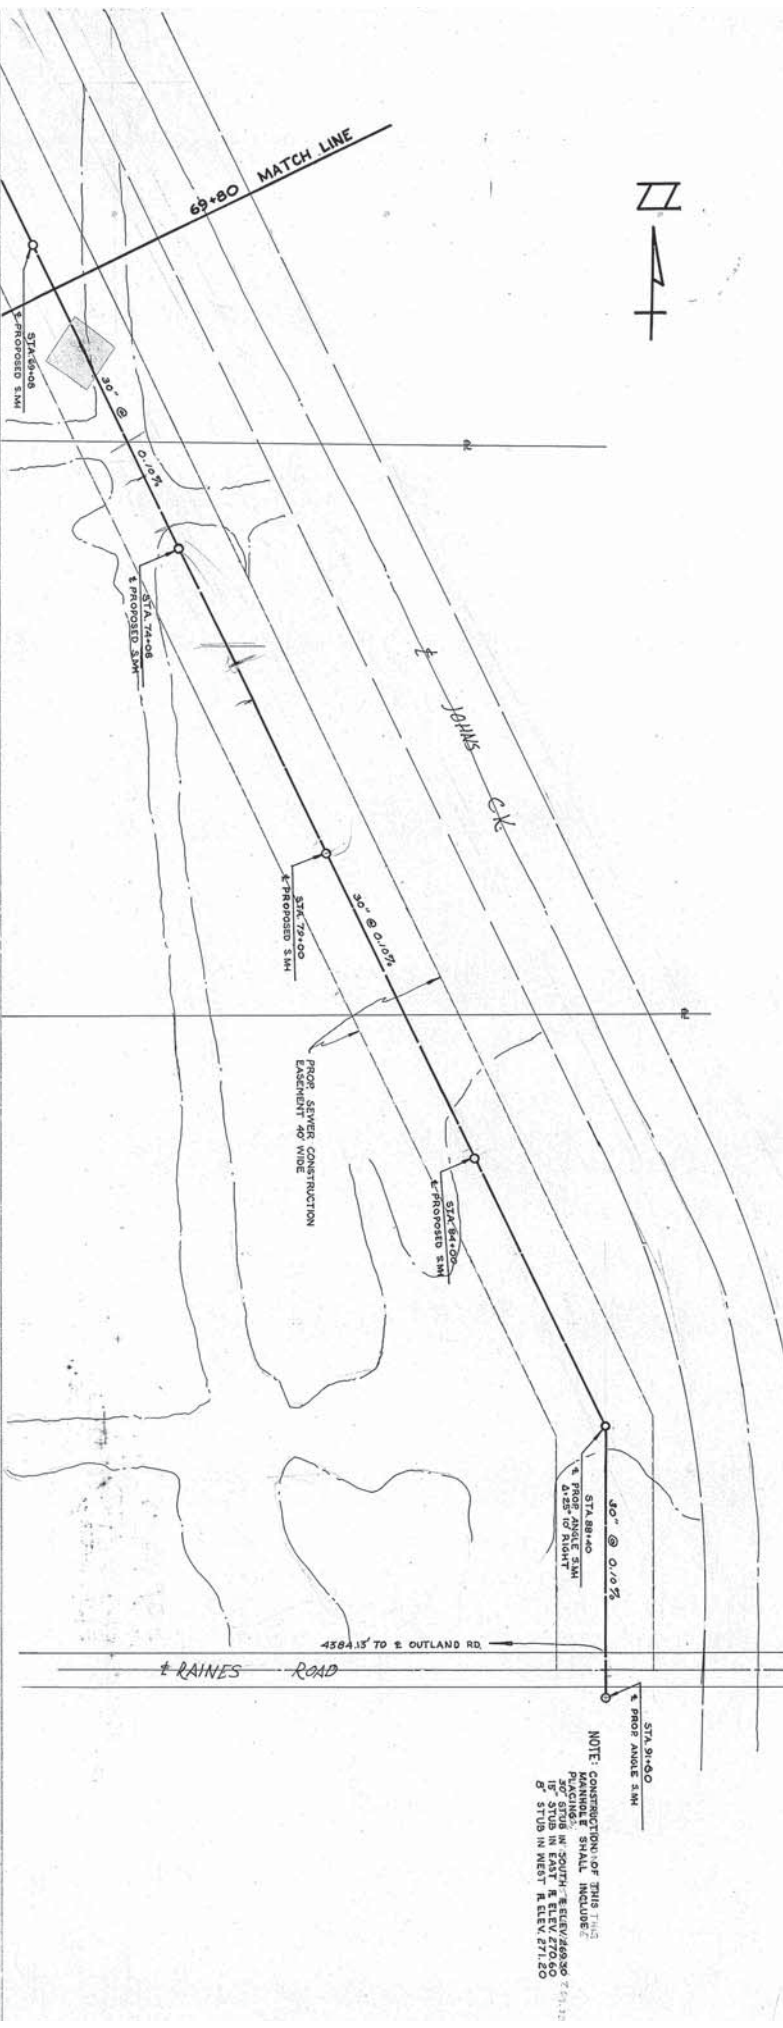

NOTE: CONSTRUCTION OF THIS LINE SHALL BE IN ACCORDANCE WITH THE STANDARD SPECIFICATIONS FOR PUBLIC WORKS OF THE STATE OF TENNESSEE. MANHOLES SHALL INCLUDE 18" STUB IN EAST & ELEV. 270.60 & 18" STUB IN WEST & ELEV. 271.20

41 015
 SANITARY SEWER CONTRACT NO. 1966-1
 SHEET 3 OF 3
 DEPT. OF PUBLIC WORKS
 DIVISION OF SEWERAGE & WATER
 WINCHESTER ROAD TO
 JOHN'S CREEK SEWER DISTRICT
 MEMPHIS, TENN.

DATE: 10/22/45
 DRAWN: M. J. DALL
 DESIGN: C. H. S.
 APPROVED: [Signature]
 CITY ENGINEER

PLAN NO. 111-1000
 SHEET NO. 17